
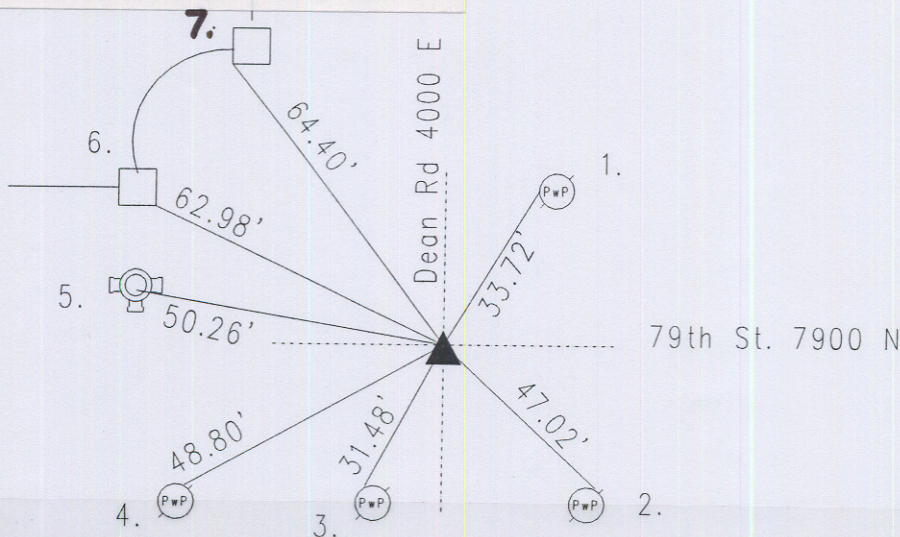


OFFICE OF THE MARION COUNTY SURVEYOR
SECTION RECORD CORNER
SECTION 29 TOWNSHIP 17 RANGE 4
DATE: 10-25-07
PARTY CHIEF: Wilcoxon
CREW: _____
TYPE OF MARKER: Harrison
METHOD OF ESTABLISHMENT: County: 9-7-02

IN.S.P.C. E ZONE, NAD'83
Name: 17042902
N: 516251.5988(m)
E: 63086.7447(m)
Corrected coords 4-15-08

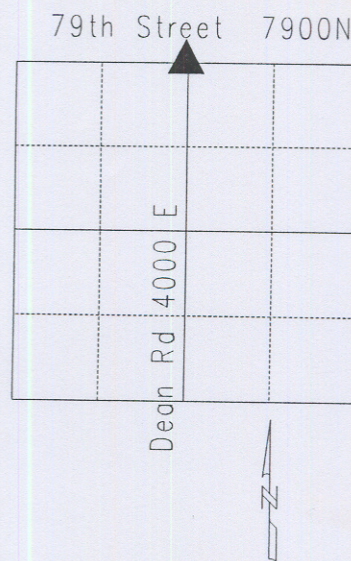

17042902 N Q

CORNER HISTORY: A survey by Wm. B. Laughlin dated 1820 called witness: 14" beech S 62 E 27 links; 30" sugar N 28 W 26 links per Marion County Atlas pg. 12. Reference dated 3-12&13-1861 called all witnesses 'dead' per Washington Township Legal Survey Book pg. 12. Survey by Fatout dated 10-27-1882 called found rock S $\frac{1}{4}$ of 20-17-4 per Washington Township Legal Survey Book pg. 78 and 81. Old tie card dated 2-25-1959 by Hankins called railroad spike found 1" down. Reference dated 9-8-1971 by SeFranka called railroad spike found 4" down. Reference dated 3-23-1976 by Miller called railroad spike found 6" down. Reference dated 8-13-1987 by Jacobs called railroad spike. Reference dated 9-7-2002 by Wilcoxon called pk nail found. Reference dated 10-25-07 by Wilcoxon called found railroad spike down 8"; found stone 14" down; set Harrison monument on top of stone. Correction made to the coordinates 4-15-08.

REF.	DISTANCE	DESCRIPTION
1.	33.72'	Mag nail w/bw W PwP#198-242 10"up
2.	47.02'	Mag nail NE PwP no# 12"up
3.	31.48'	PK nail w/washer NW PwP#42-242 12"up
4.	48.80'	Mag nail w/bw N PwP#239-242 12"up
5.	50.26'	Top nut of fire hydrant
6.	62.98'	SF corner of stone column 3rd stone up
7.	64.40'	SW corner stone column 5th stone up